

**INTERFACE**

111 S 344th St. #202  
 Federal Way WA 98003  
 Tel: 206 243-6202  
 Fax: 206 836-9705

DECATUR HIGH SCHOOL  
 100 S.W. 320th STREET  
 FEDERAL WAY, WA 98023

Date: 1/24/96

Client: DECATUR COOL

As Bldg

Designed by: MIKE HEFFERMAN

Checked by: Joe Hubbard


Scale: None


Sheet: 11 of 11

Location: REV C MH 2/12/96

Legend

- Communication Outlet
- MDF Location
- IDF Location
- Existing Coils Network
- 1" Outdoor Inneeduct
- Fiber Backbone
- 1" EMT Conduit
- Power/Data Poles
- Communication Pole
- Column
- Pull Box

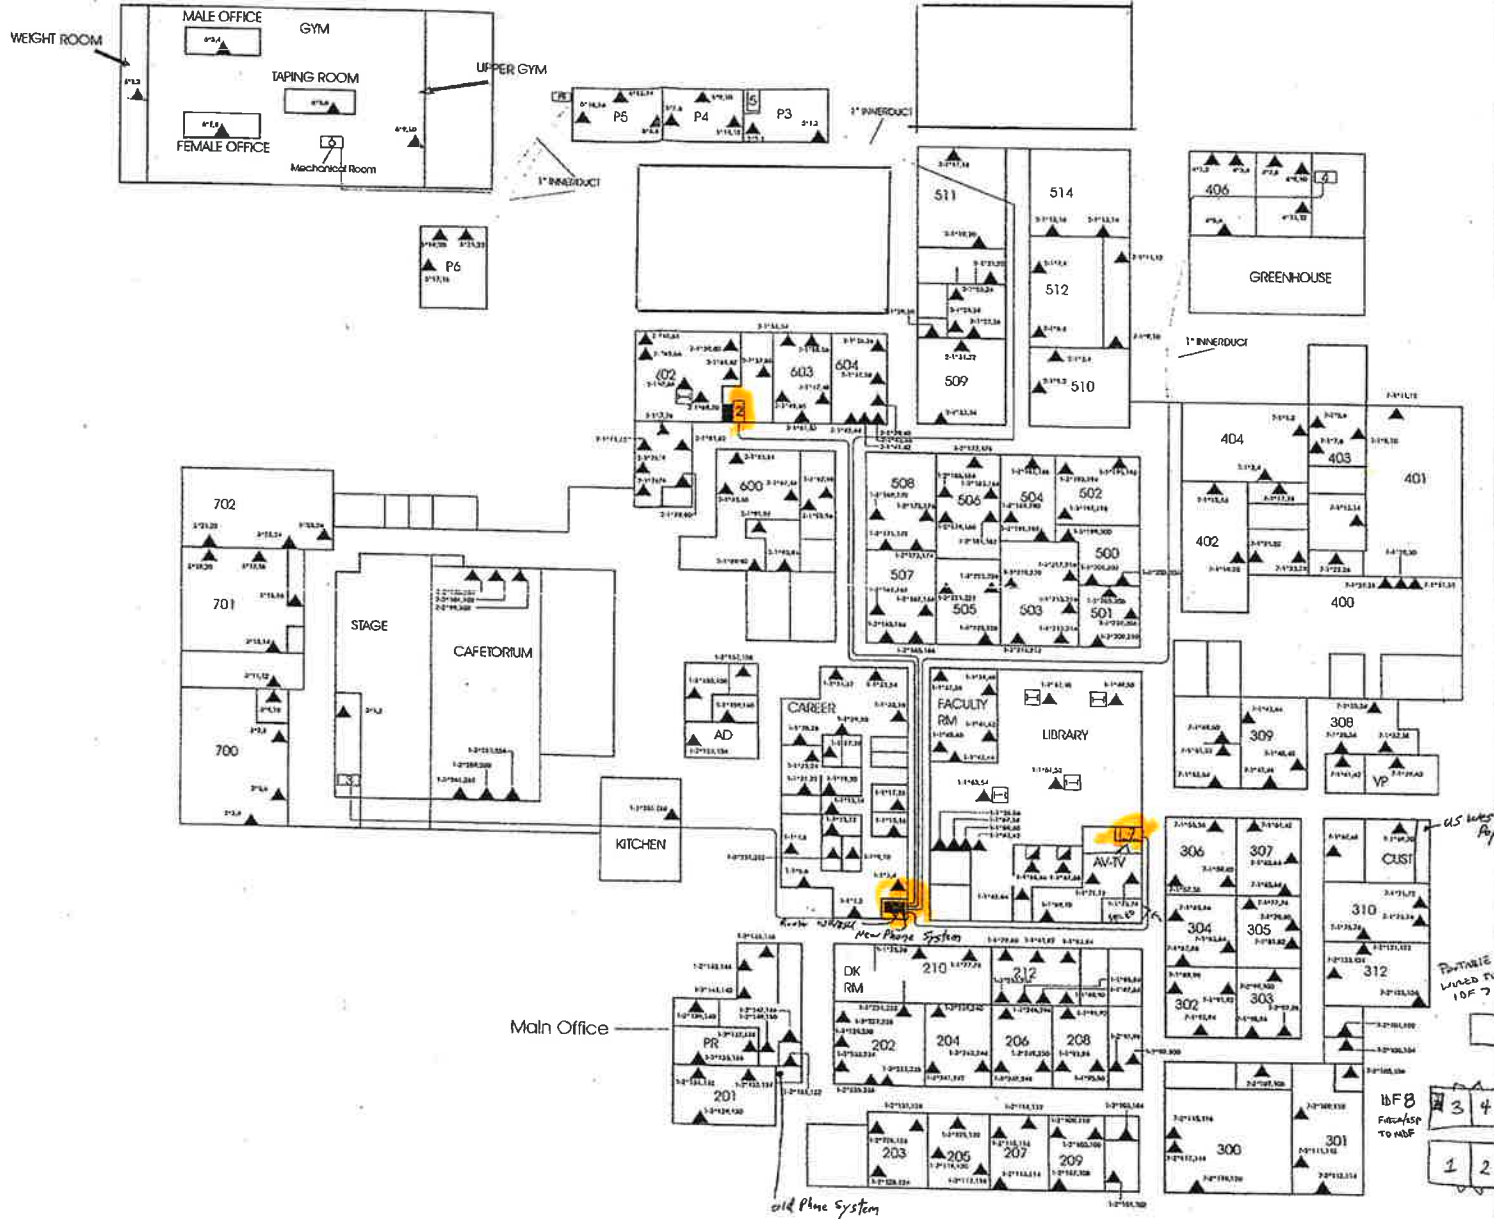

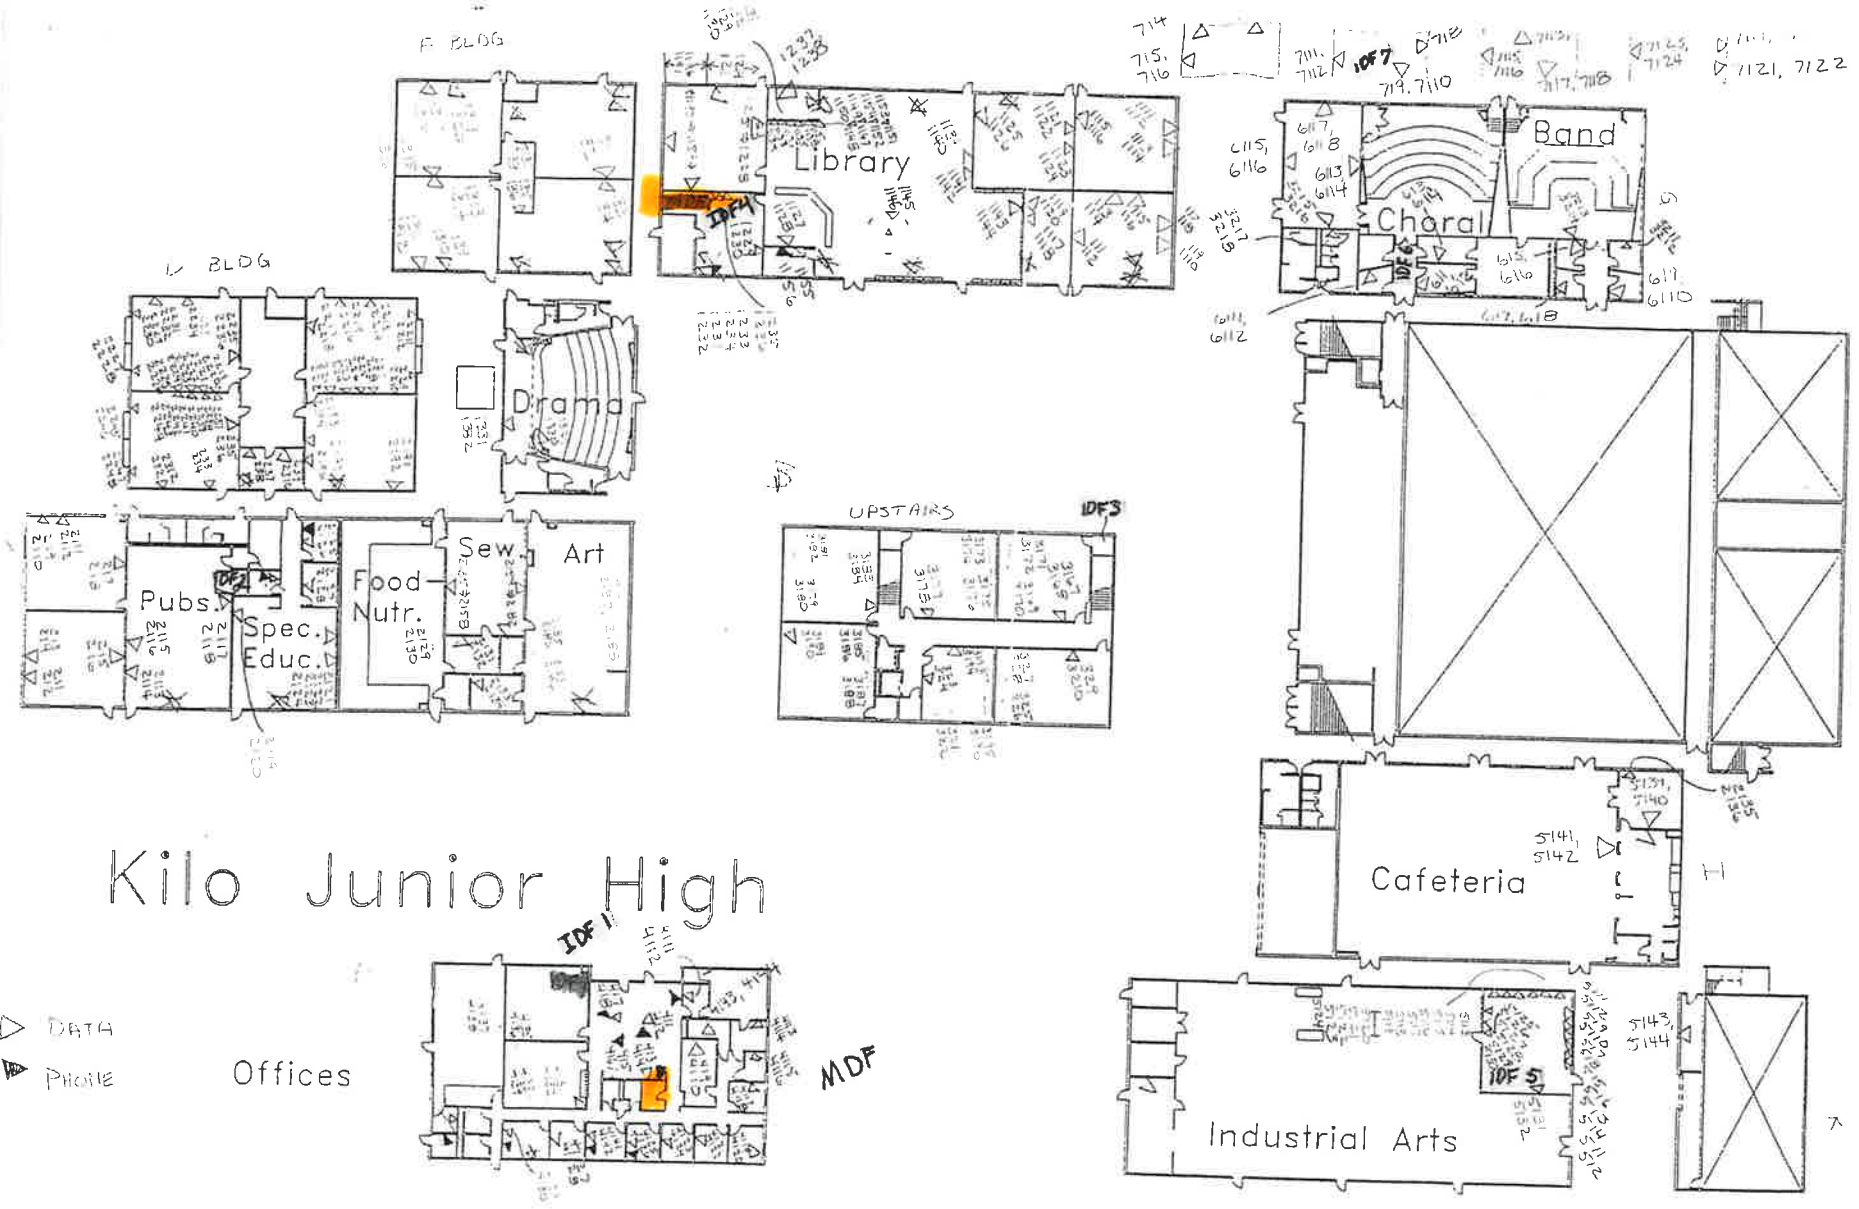

# Kilo Junior High

Offices

MDF

IDF 5

7



1111 S 344th St #202  
Federal Way WA 98003  
Tel: 206 243-6202  
Fax: 206 838-9705




Olympic View Elementary  
2626 S.W. 327th Street  
Federal Way, 98023

Date: 01/15/97  
File name: Olyview.cdr  
Title: As Built  
Drawn by: Mike Heffernan  
Checked by: Keith Haller  
Scale: None  
Sheet 1 of 1  
Revision: REV C MH 02/25/97

**Legend**  
▲ = Communication Outlet  
■ = MDF Location  
□ = IDF Location  
— = Fiber Backbone  
— = Power/Data Pole  
= 1" Outdoor Innerduct


838-2756  
838-7251

Notes:

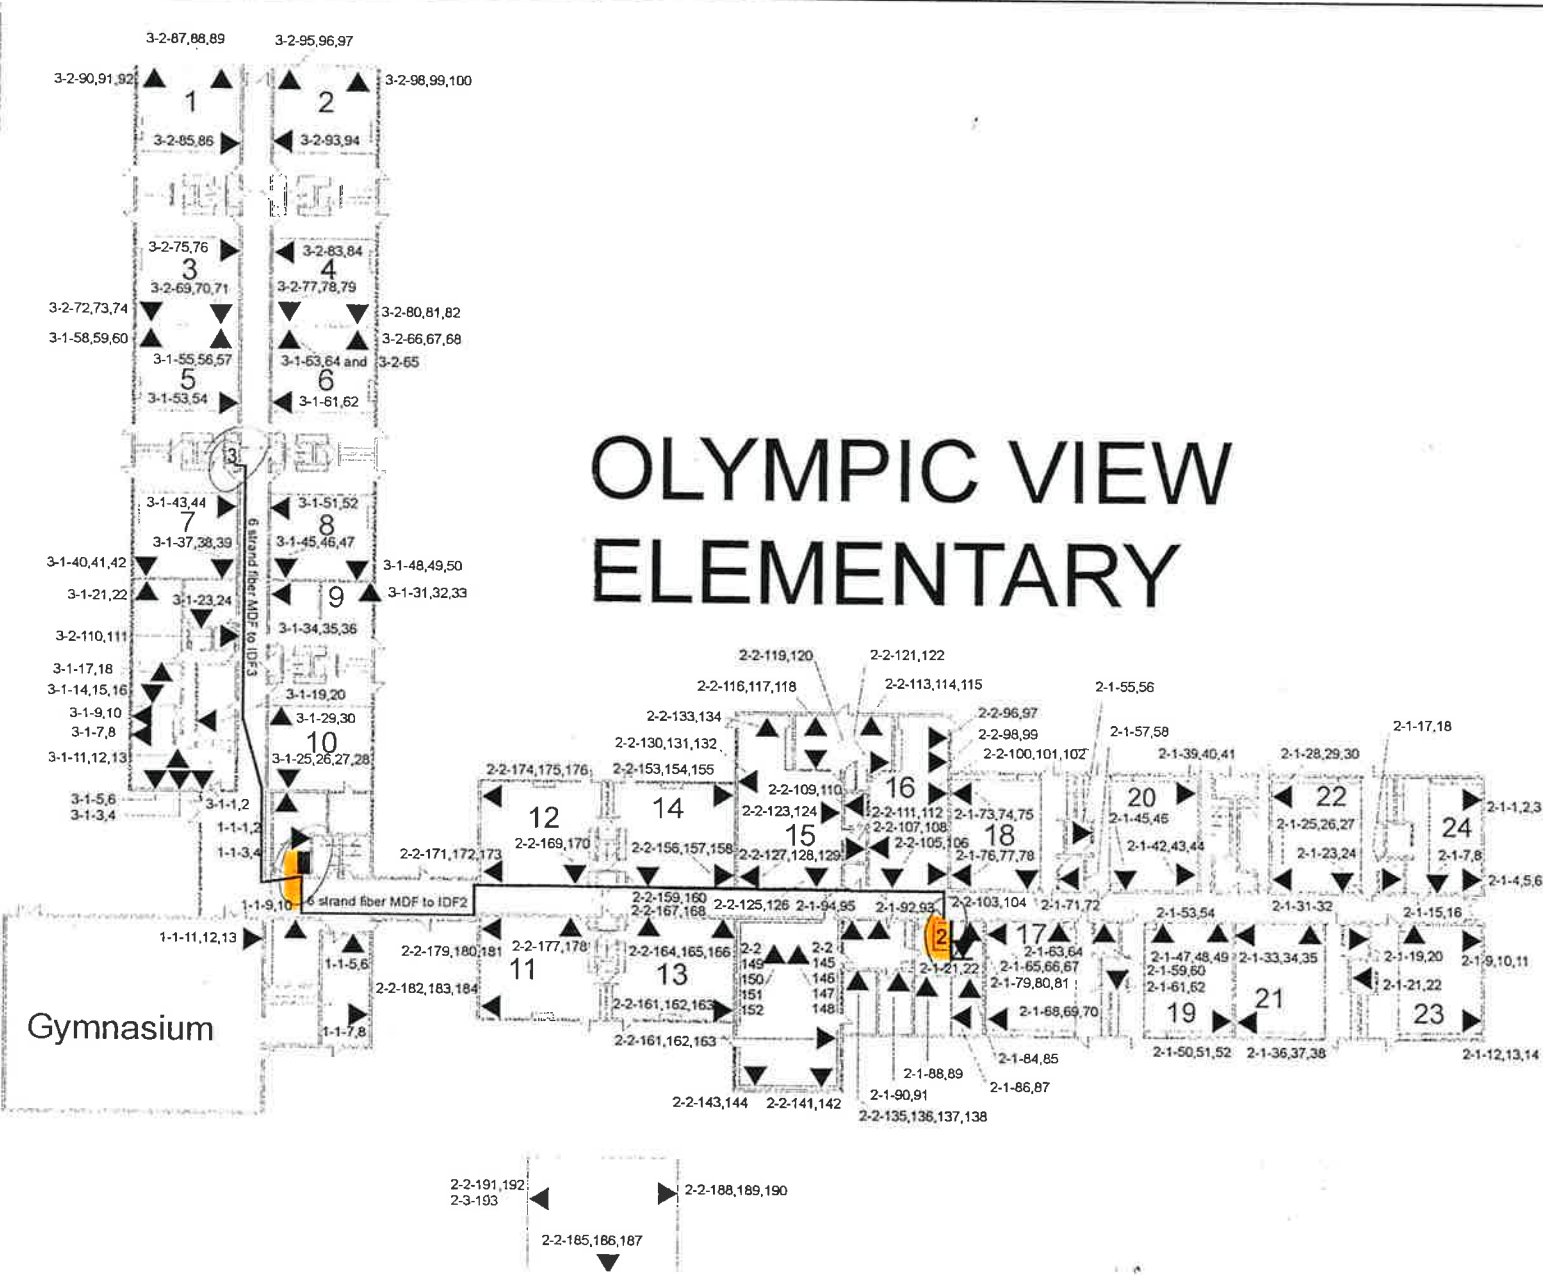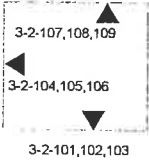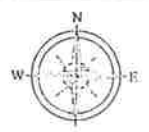


Gymnasium




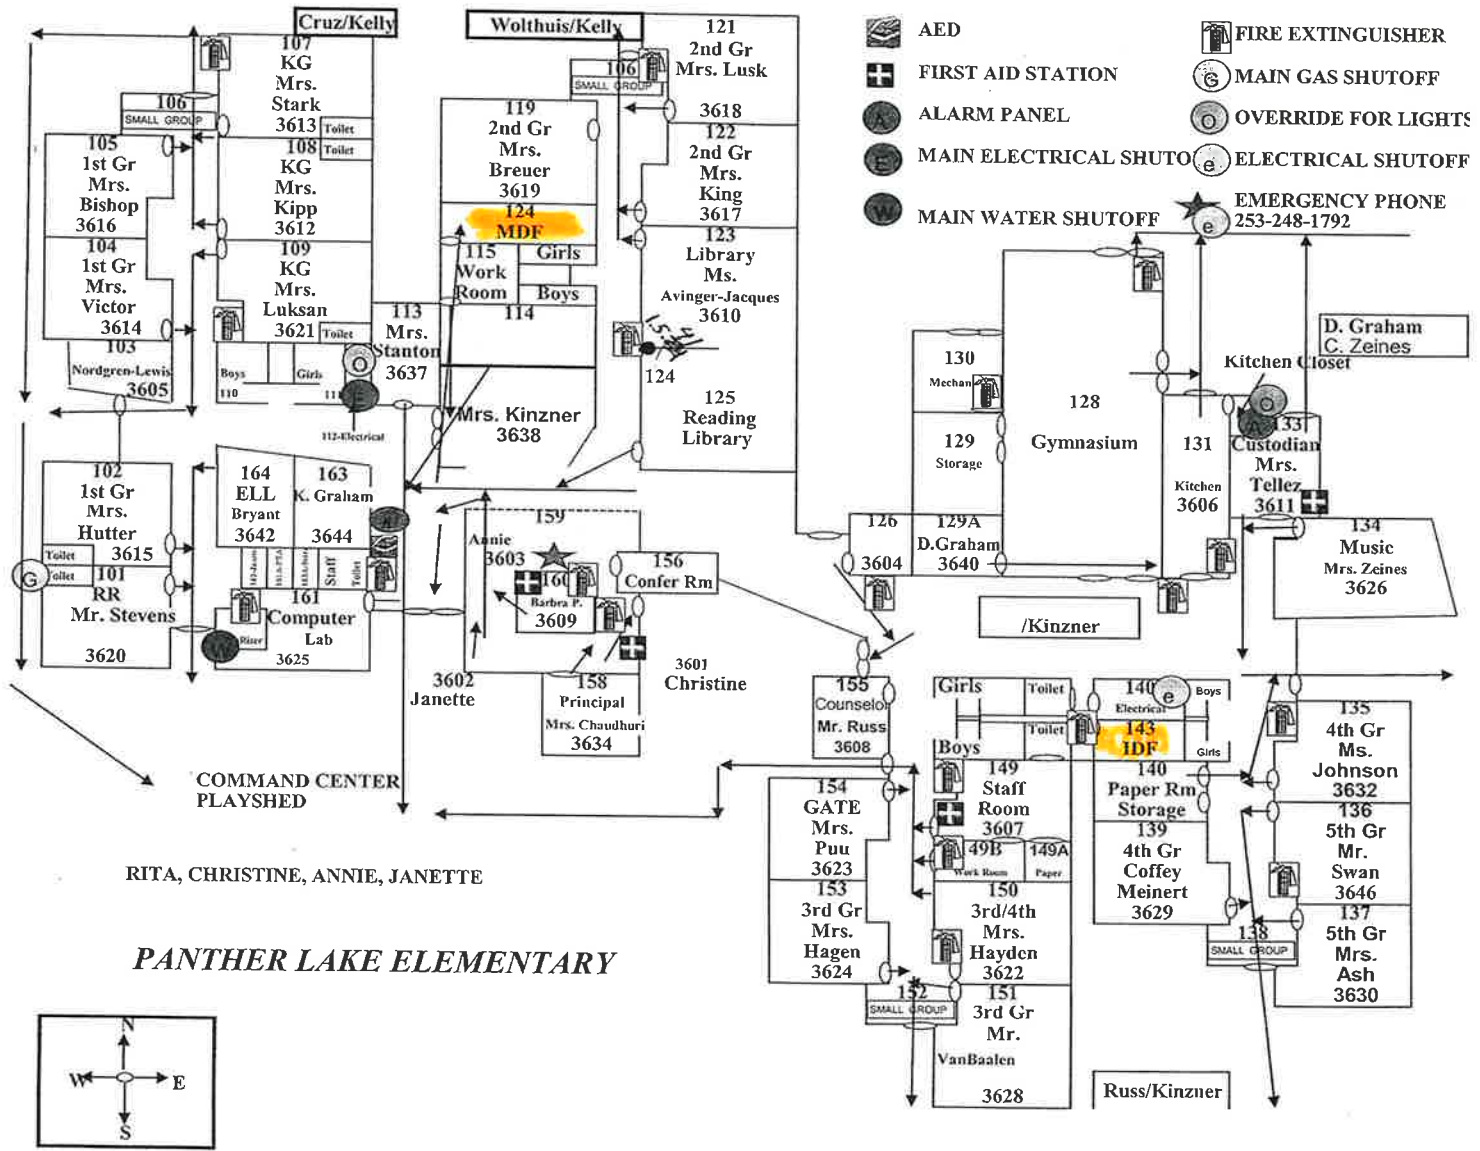


**PANTHER LAKE ELEMENTARY**

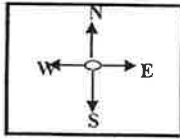

# SUNNYCREST

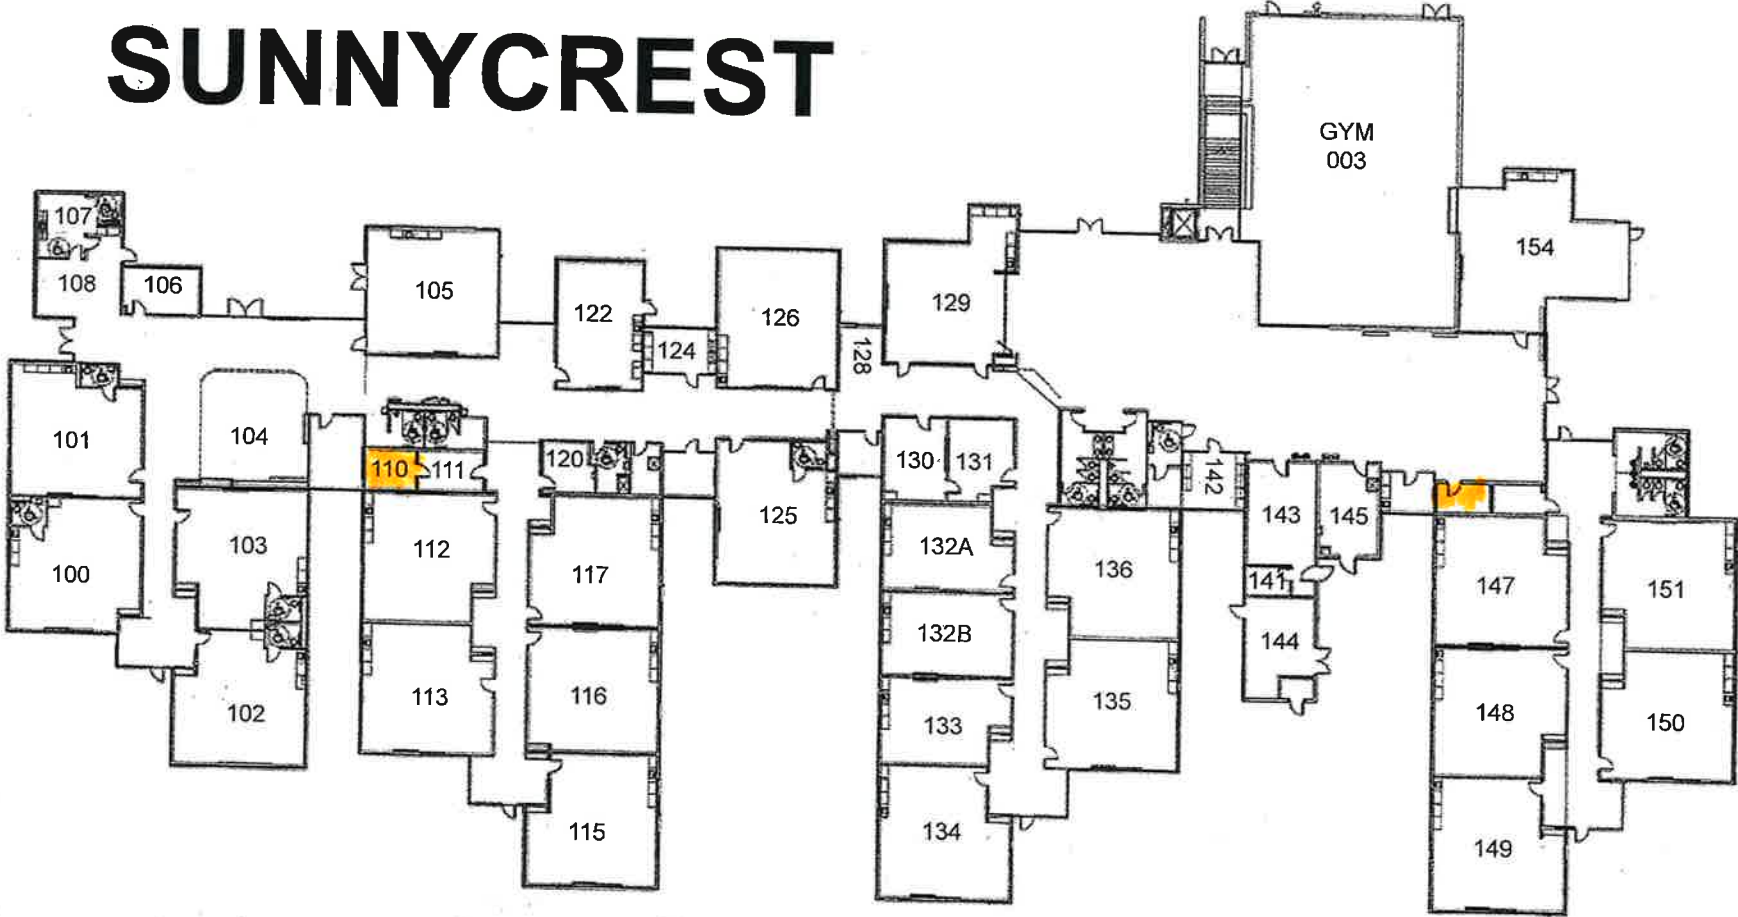

# SAGHALIE JUNIOR HIGH

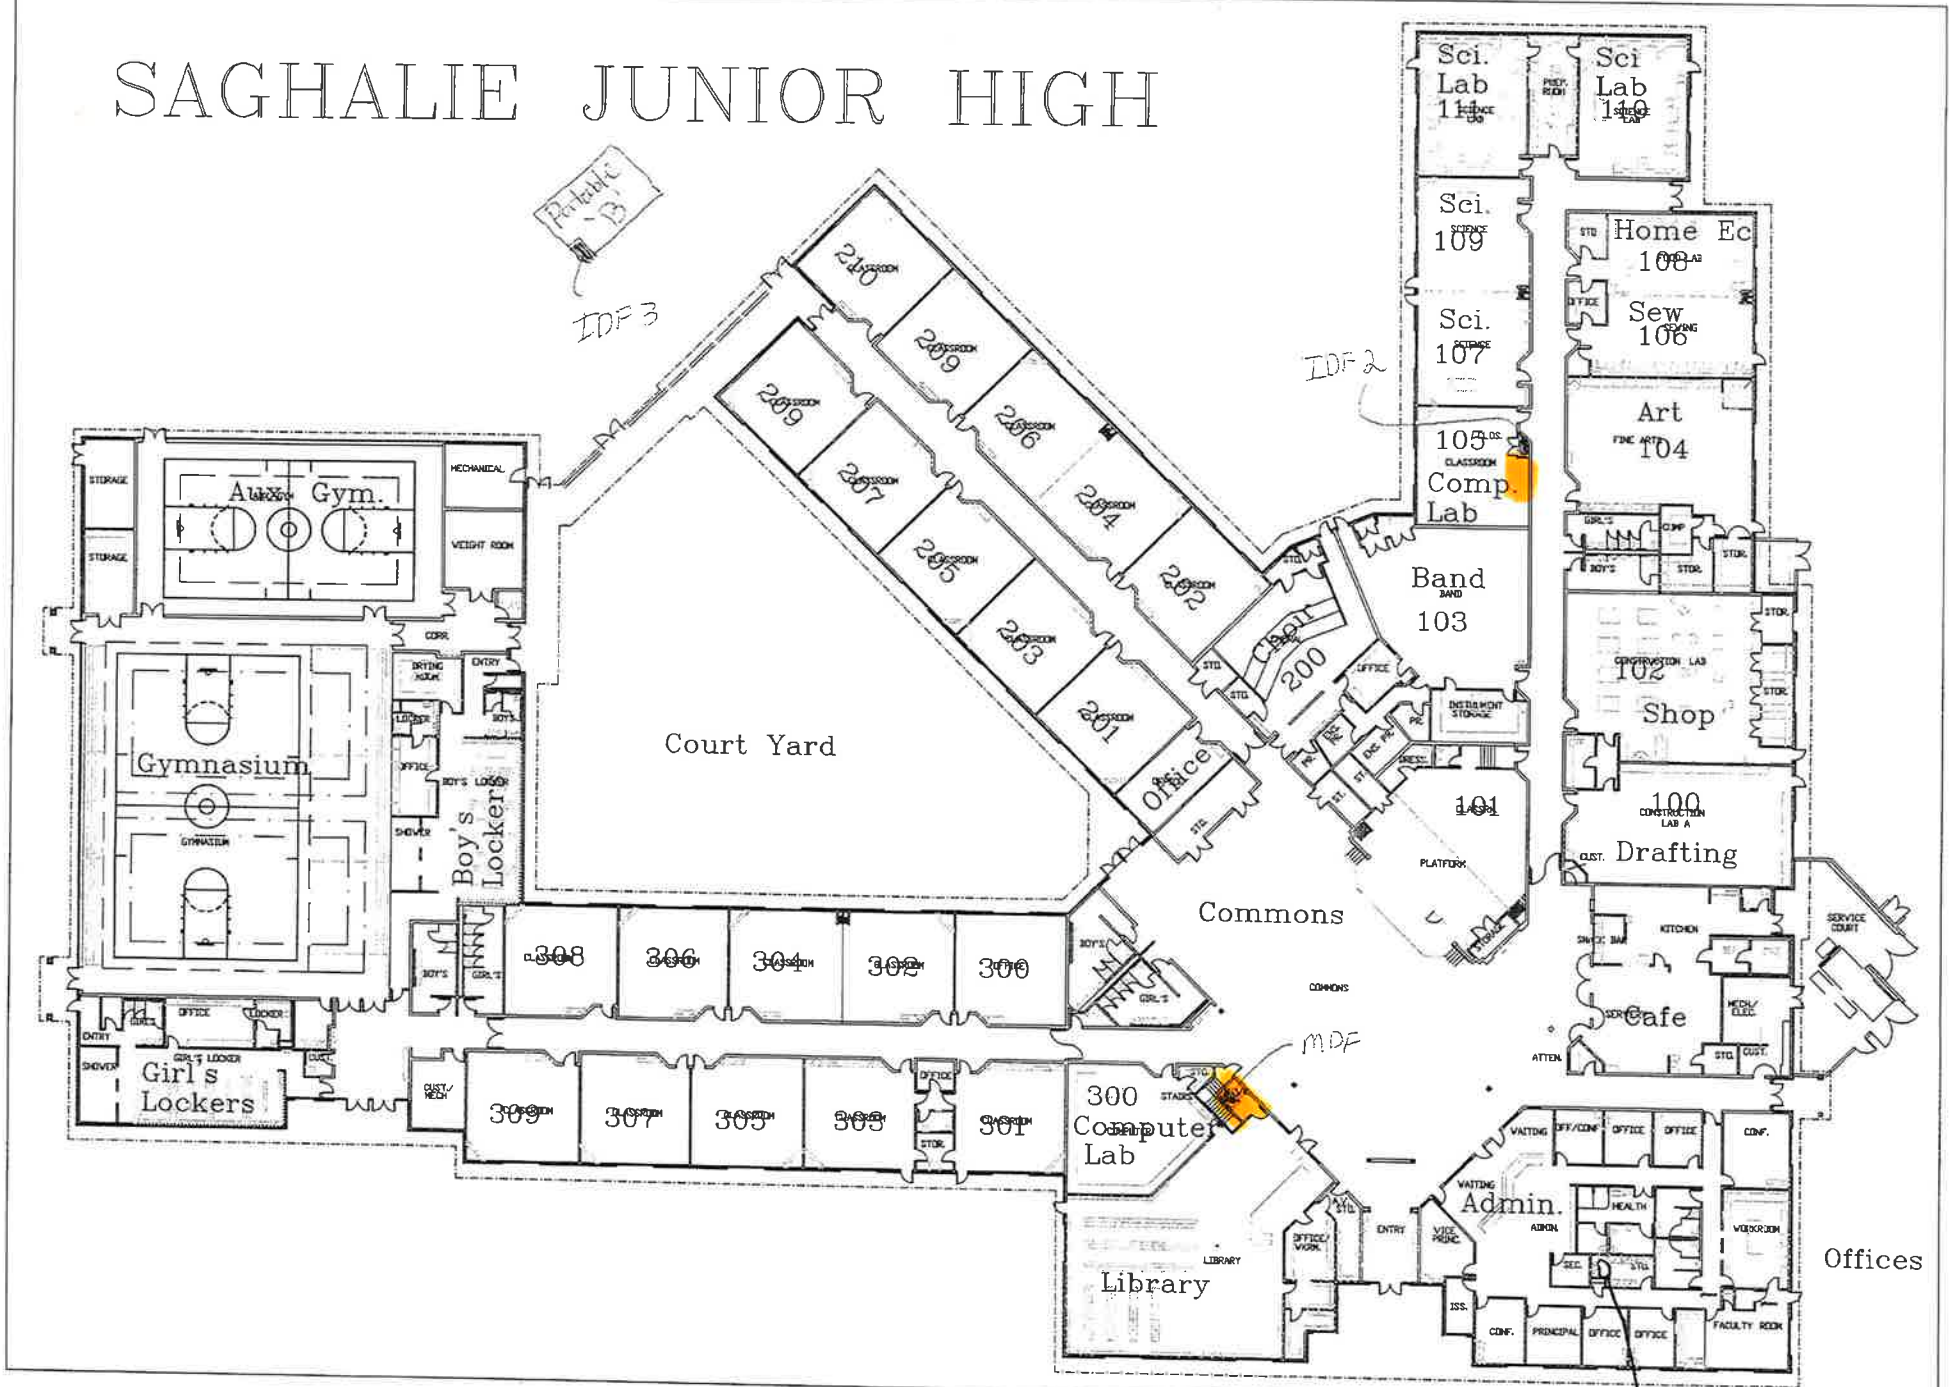





TODD BEAMER  
DOWNSTAIRS  
LEVEL